



Falls Chapel Way ⇔ Falls Chapel Way D3-2 DUAL-FACED VARIABLE X 16"

CONSTRUCTION DETAILS


- A. Install 27' steel pole with a special 15' "T" dimension, 50' mast arm. (cut to 46') traffic signal heads, pedestrian signal heads, signs and video detection camera, splice cabinet and audible pushbutton with pedestrian education sign, 3" weatherhead and 20' lighting arm with a 250HPSV luminaire. See Detail "N". (Note: 1-3", 90° polyviny) chloride (Schedule 80) bend.)
- B. Install 16.5' steel pole with a special 15' "T" dimension, 50' mast arm, traffic signal heads, pedestrian signal head, signs and video detection camera. (Note: 1-3", 90° polyvinyl chloride (Schedule 80) bend.)
- C. Install 16.5' steel pole with a special 15' "T" dimension. 34' mast arm. traffic signal heads. pedestrian signal head. signs and video detection cameras. (Note: 1-3". 90° polyvinyi chloride (Schedule 80) bend.)
- D. Install 16.5' steel pole with a special "T" dimension, 32' mast arm, traffic signal heads, signs and video detection camera. (Note: 1-3", 90° polyvinyl chloride (Schedule 80) bend.
- E. Install 10' breakaway pedestal pole, Countdown pedestrian signal head, relocated sign and audible pushbutton with pedestrian education sign as shown. (Note: 1-3", 90° polyvinyl chloride (Schedule 80) bend.)
- F. Install 5' breakaway pedestal pole, audible pushbutton with pedestrian education sign. (Note: 1-3", 90° polyvinyl chloride (Schedule 80) bend.)
- G. Install NEMA size "6" base-mounted cabinet and controller with video interface and all necessary equipment shown.
- H. Install handhole.
- J. Install 2" polyvinyl chloride electrical conduit (Schedule 80) (trenched).
- K. Install 3" polyvinyl chloride electrical conduit (Schedule 80) (trenched).
- L. Install 4" polyvinyl chloride electrical conduit (Schedule 80) (trenched).
- M. Install 4" polyvinyl chloride electrical conduit (Schedule 80) (bored).
- N. Disconnect existing overhead interconnect cable from existing base mounted cabinet and pull back to this utility pole. Reroute interconnect cable to proposed mast arm pole "C" and into proposed splice cabinet.
- g. Rerouted overhead interconnect cable.
- p. Remove existing strain pole and all attached signal equipment. Cap and abandon existing conduit.
- q. Remove existing handhole. Cap and abandon existing conduit.
- R. Remove existing base mounted cabinet and controller and foundation 12" below grade. (Note: Controller shall be delivered to the Montgomery County Signal shop).
- S. Install meter pedestal for electrical service.
- T. Install 3" polyvinyl chloride electrical conduit (Schedule 80) (trenched) with 35' of 3 wire 1 conductor (No. 250 KCMIL) and pull string for power service to base of utility pole for proposed underground electrical service by PEPCO.
- U. Existing overhead 12 pair interconnect cable.
- v. Install 12" white, heat applied permanent preformed thermoplastic pavement marking (crosswalk). 12" diagonal crosshatching is to be installed by the contractor. Not shown on plan for clarity purposes.
- w. Install 24" white, heat applied permanent preformed thermoplastic pavement marking (stopline).
- x. Remove existing "stopline" pavement marking.
- y, Remove existing "crosswalk" pavement marking.
- z. Remove existing ground mounted signs and post. Relocate signs to proposed pedestal pole (See Construction Detail "E") as shown.
- aa. Relocate existing ground mounted sign #17.
- bb. Relocate existing ground mounted sign #18.
- cc. Install ground mounted R9-5(mod) sign as shown.

GEOMETRIC LEGEND			
PROPOSED			
EXISTING			
LEGEND OF UNDERGROUND			
AND OVERHEAD UTILITIES			
AERIAL CABLE			
ELECTRIC —— E —— E ——			
TELEPHONE — T — T —			
GAS — • — • —			
SEWER —— s —— s ——			
WATER			
CABLE TV ——TV——TV——			

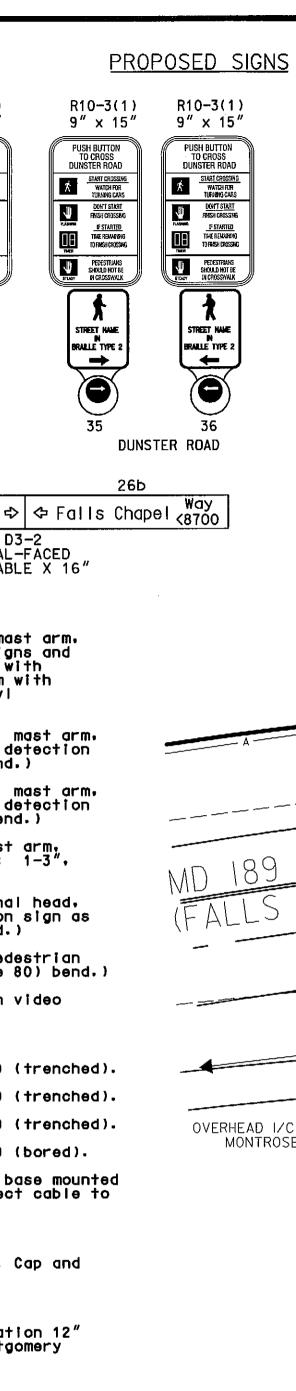

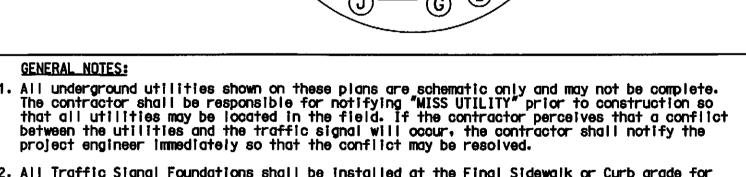

- 2. All Traffic Signal Foundations shall be installed at the Final Sidewalk or Curb grade for closed sections. Highest Roadway Profile Grade for open sections, to meet clearances as specified in MD 816.03, MD 818.01, MD 818.02, and MD 818.04 The contractor shall verify ultimate grades prior to the installation of all signal equipment.
- 3. All pavement markings detailed are proposed and are to be installed in accordance with SHA standards. All crosswalks shall be centered on handicap ramps or median cut throughs.
- 4. Pushbuttons are to be located so that they can be activated by a person in a wheelchair reaching less than 18" from a 60"x 60" level landing area with a cross slope of less than or equal to 2%.
- 5. The 10' separation between pushbuttons is to be measured from face of pushbutton to face of pushbutton, not center to center of pole.
- 6. Pushbutton arrows are to be parallel to the crossing for which they are intended.
- Location of Accessible Pedestrian signal pushbuttons must meet location requirements Of MUTCD Sec. 4E.09 and Fig. 4E.2 and the NCHRP publication. Accessible Pedestrian signals: Guide to Best Practice. If not met, the Contractor is to stop work on pushbutton locations until a design Waiver is obtained, approved by the Director, Office of Traffic and Safety.
- 8. The contractor shall remove all unused wiring.

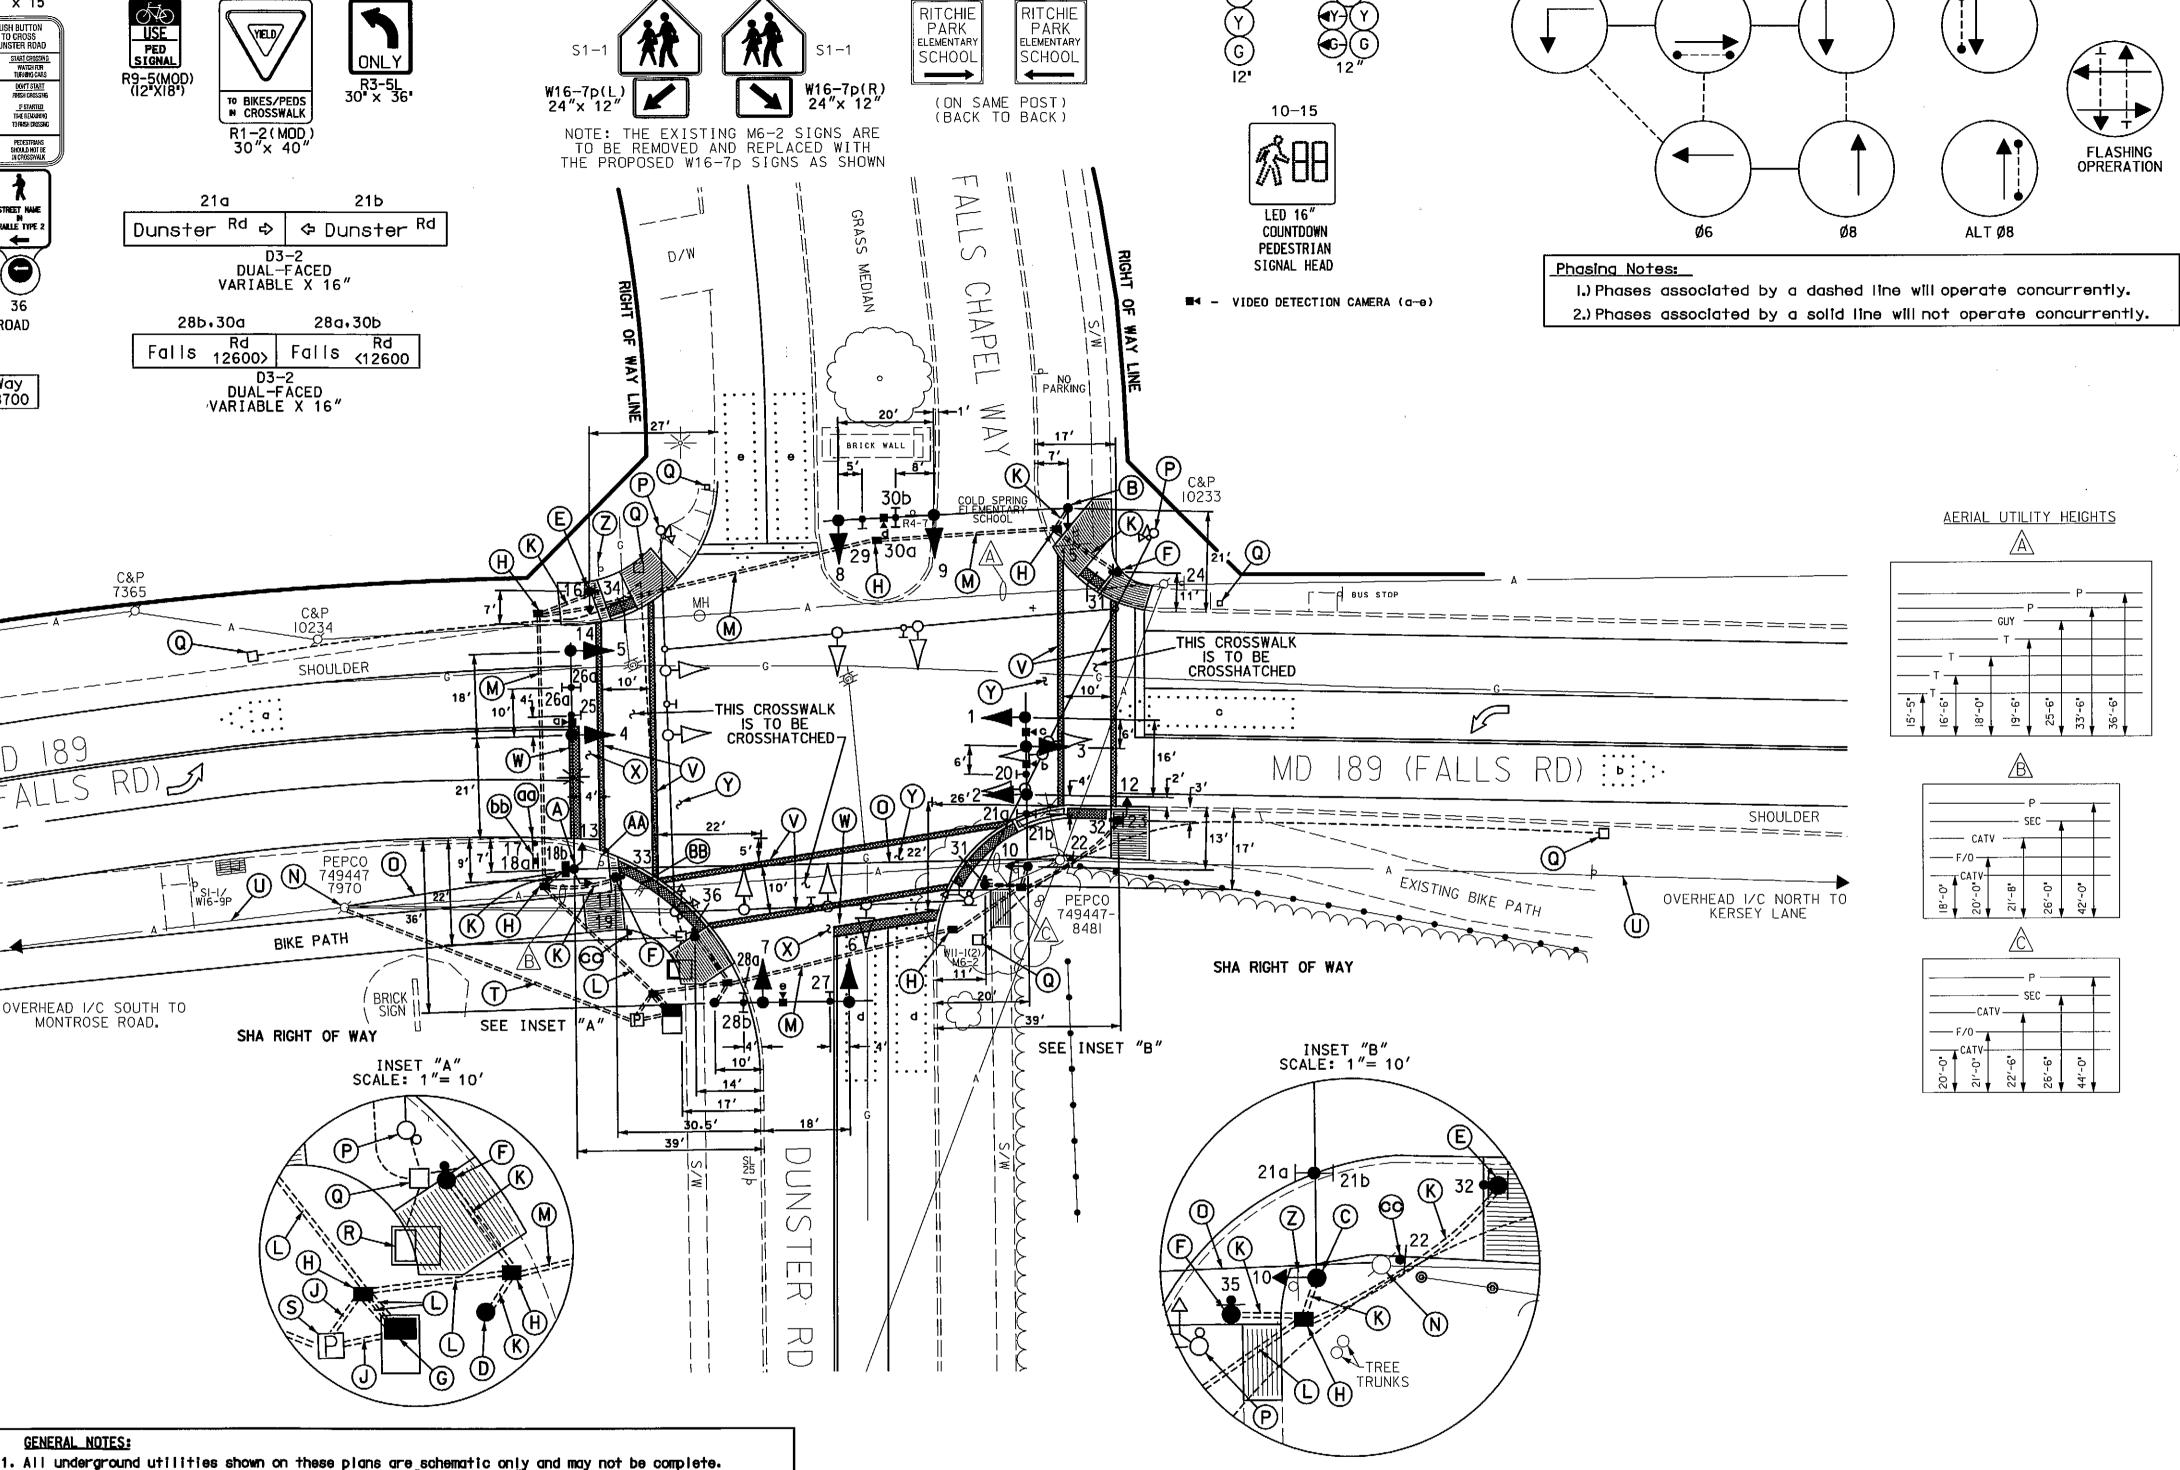

PROPOSED LED SIGNALS

1.2.5-9

EXISTING SIGNS (TO BE RELOCATED)

18a

ELEMENTARY

RITCHIE Park

EL EMENTAR

16,24

NEMA PHASING

ALT Ø4

STATE OF MARYLAND DEPARTMENT OF TRANSPORTATION STATE HIGHWAY ADMINISTRATION

MD 189 (FALLS ROAD) AND DUNSTER ROAD / FALLS CHAPEL WAY

ROCKVILLE, MARYLAND



FILE: \$FILE\$

5151g.DGN

APPROVALS	REVISIONS	TRAFFIC S	IGNAL PLAN	
(1)E	D II-30-09 REBUILD SIGNAL DUE TO NEW BIKE PATH SHA NO.; BW996M82	SCALE 1"= 20' DATE	CONTRACT NO	
DIV. CHIEF	RRZ 2-07 Install pedestrian signal heads on north and edst leas SHA NO.: XXI065285 JH B 2-4-99 Asbuilt SHA NO.: MO 5715176	DRAWN BY CHECKED BY	COUNTY MONTGOMERY LOGMILE 15018905.80 TIMS NO. 1807 TOD NO.	
DIRECTOR	RRZ	TS NO. 3879D DRAWING NO. 1	OF 2 SHEET NO. OF	
	PLOTTED: #DATETIME\$			